



DATE: November 23, 1981

TO: Division File

FROM: Craig J. Liska

SUBJECT: DuPage County - LPC - 04380301
Lisle Twp./Greene Valley Leachate Collection System

EPA Region 5 Records Ctr.



The 12 foot lengths of perforated pipe were being laid into position upon my arrival. A photo was taken confirming the connection of the new sections of pipe to the existing upright. (The attached diagram shows the approximate location of the newly installed pipe) The depth of the leachate collection trench varied from approximately 3 to 5 feet to accomodate the desired direction the leachate is to flow. The trench was backfilled with gravel to the original invert grade following the cementing of each 12 foot length of pipe. A layer of clay was deposited over the gravel to prevent rainwater from entering the pipe. The layer of clay is to be removed prior to the deposition of refuse in this area. A vertical upright was installed at the north end of the newly installed section of pipe.

Based on the requirements of the operating permit, the trench was approved for refuse disposal by the Forest Preserve and this regional office.

CJL:prb

cc: Northern Region
Bill Child

Date: November 23, 1981

Time: 9:00 - 11:00 A.M. ~~P.M.~~

Photograph By:

Craig Liska


Location: LPC# 04380301

DuPage Co.

Liste Twp 16 Greene Valley

Comments: Photograph taken

toward the north from
the northwest portion
of the site

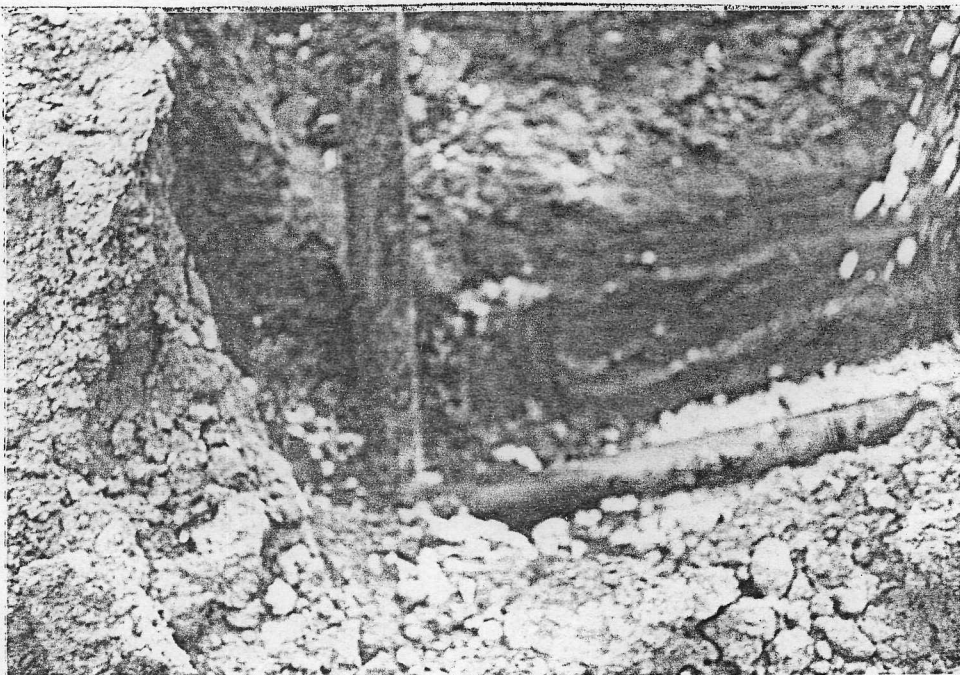

Date: _____

Time: _____ A.M. P.M.

Photograph By:

Location: _____

_____ Co.

Comments: Photograph taken

toward the

Date: November 23, 1981

Time: 9:00 - 11:00 A.M. ~~P.M.~~

Photograph By:

Craig Liska

Location: LPC # 04380301

Du Page Co.

Liste Twp. 1 Greene Valley

Comments: Photograph taken

toward the northeast from
the northwest portion
of the site



Date: November 23, 1981

Time: 9:00 - 11:00 A.M. ~~P.M.~~

Photograph By:

Craig J. Liska

Location: LPC # 04380301

Du Page Co.

Liste Twp. 1 Greene Valley

Comments: Photograph taken

toward the east from
the northwest portion
of the site




11-23-81

Liste Twp./Greene Valley

LPC # 04380301

Close to Scale

1" = 800'

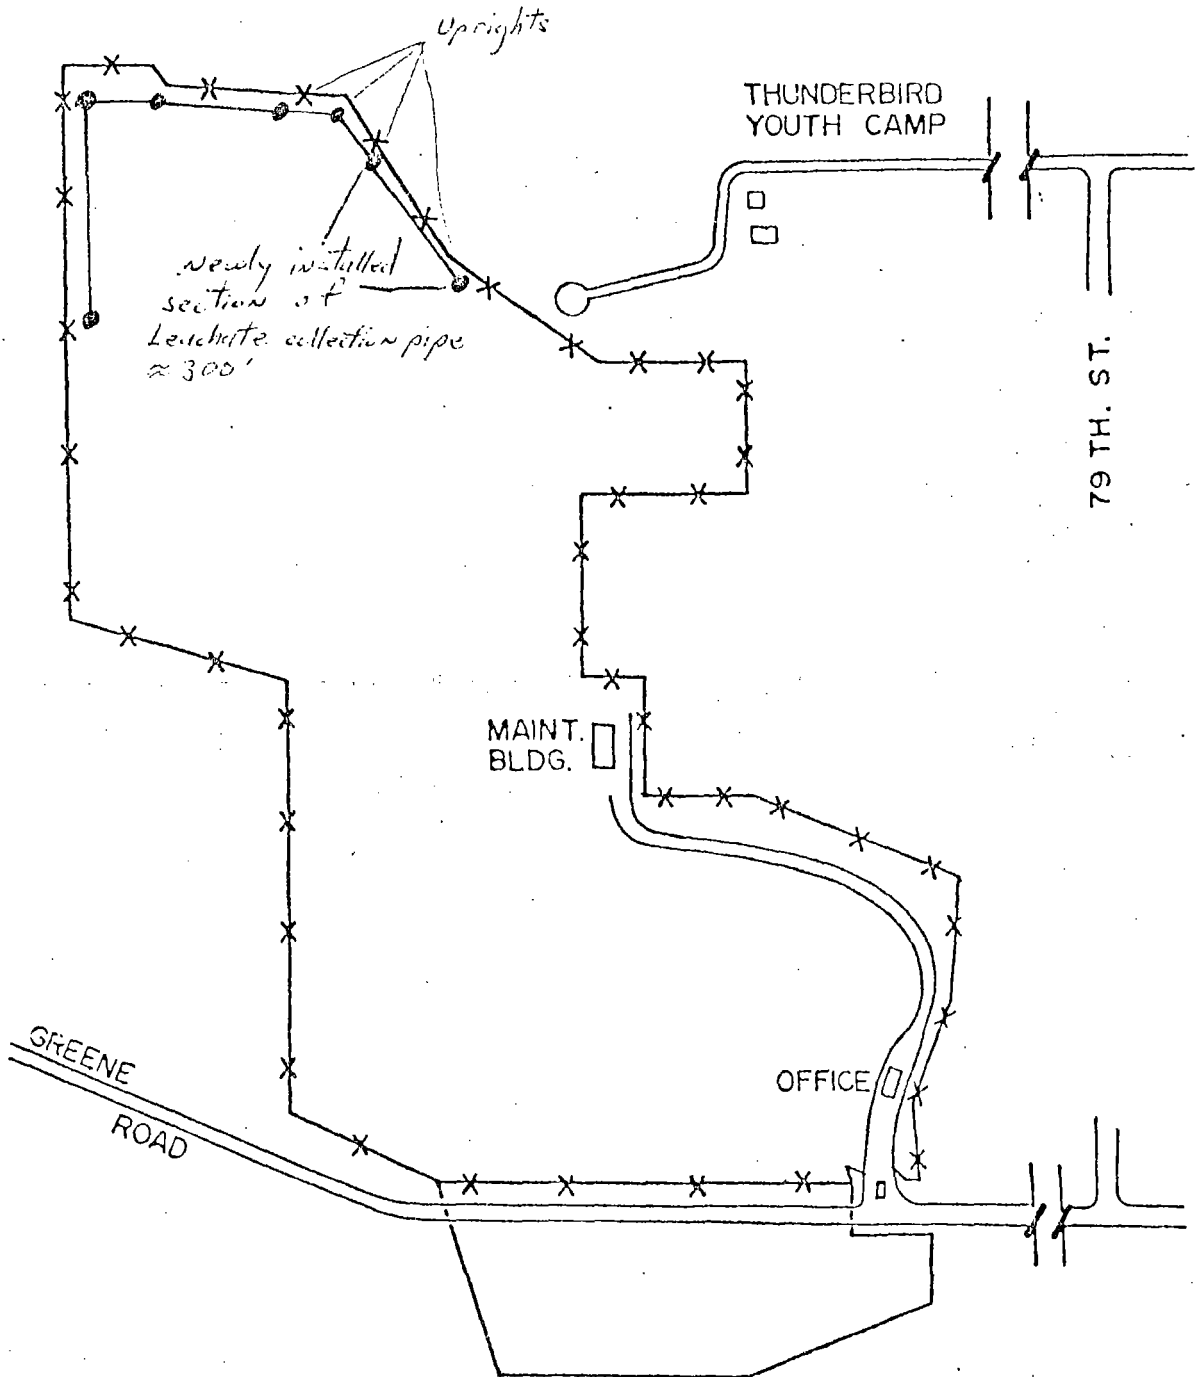

GREENE VALLEY LANDFILL



Waste Management of Illinois, Inc.

7300 College Drive • Palos Heights, Illinois 80483

P.O. Box 583

DATE

SHEET
OF

ELD